


**SUITE 1
REFLECTED CEILING PLAN**
SCALE: 1/4" = 1'-0"

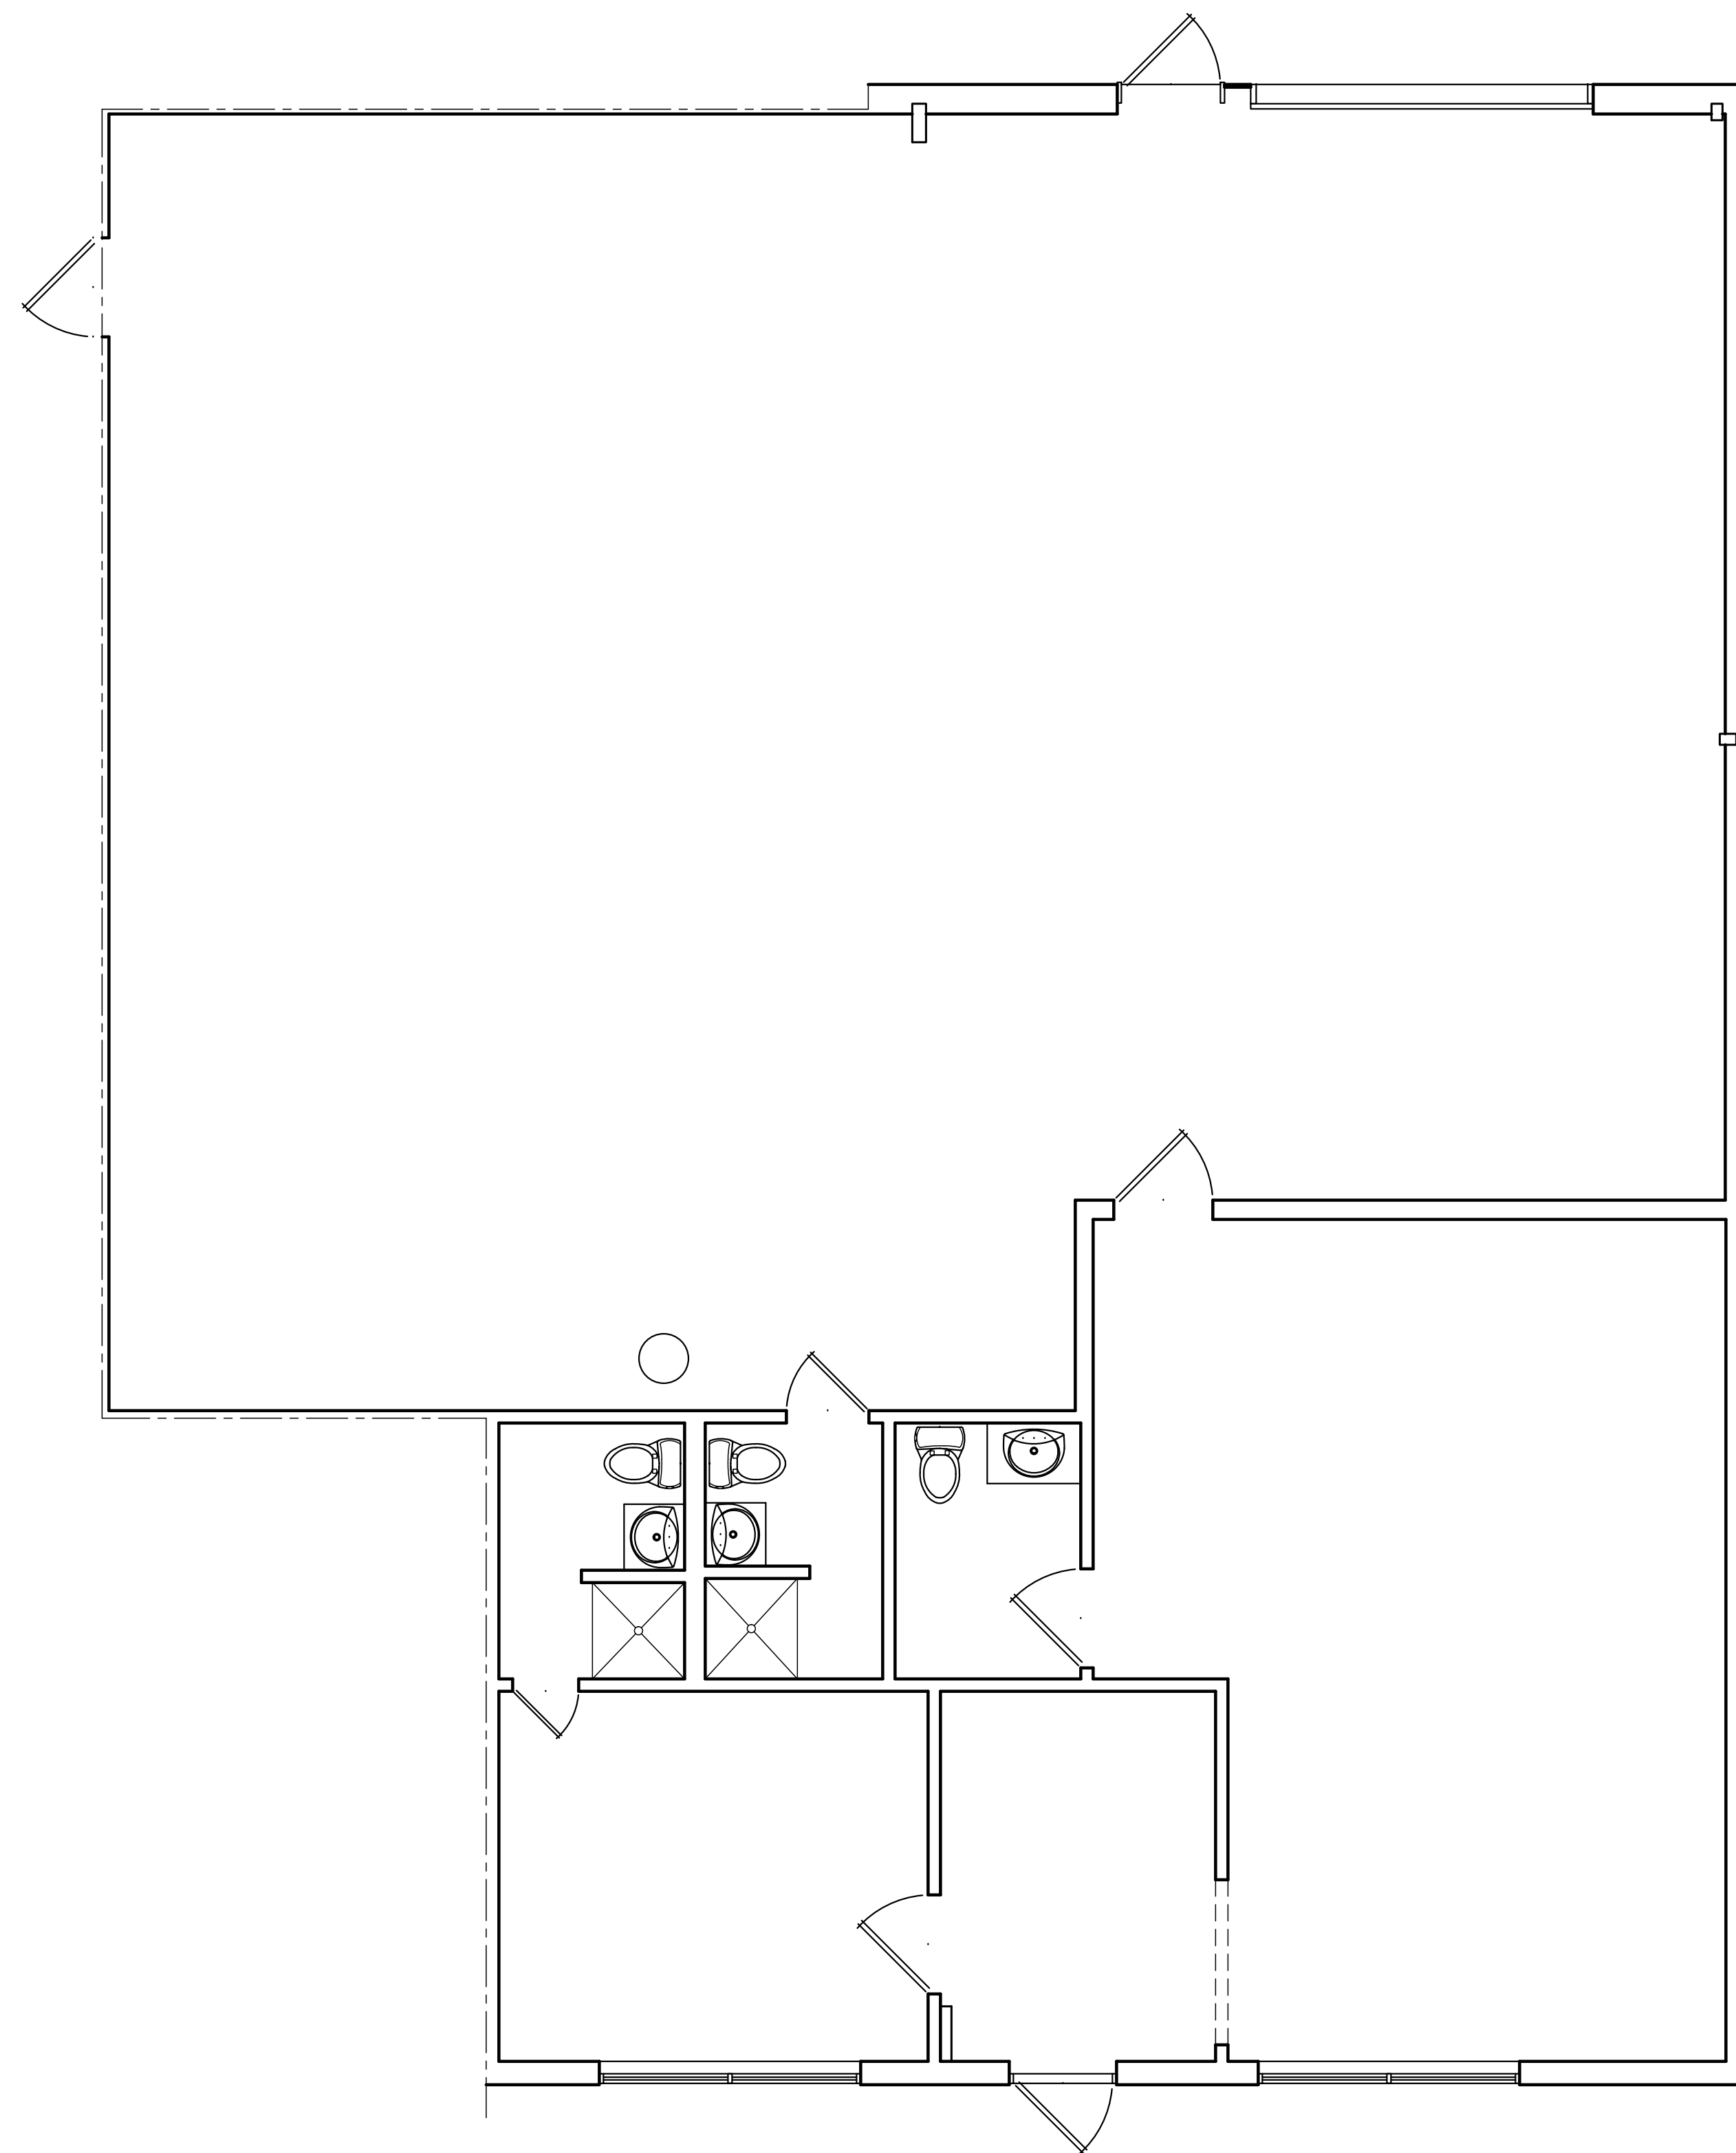


SUITE 1 PLAN
SCALE: 1/4" = 1'-0"

BUILDING AREA
SUITE 1 - 2,782 SQ. FT.

DATE REV. NO. DESCRIPTION

**West & Associates
ARCHITECTS**

4389 SHELDORNE DRIVE, DUNWOODY, GEORGIA 30338-8615 (770) 457-4485

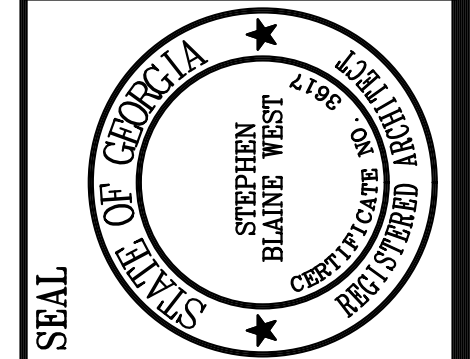

SEAL

DRAWN

CHECKED

APPROVED

SHEET TITLE
SUITE 1 PLAN & REFLECTED CEILING PLAN


PROJECT NAME
AS-BUILT SURVEY
FOR 120 GLOSTER RD. - LAWRENCEVILLE, GA

REPRODUCTION RESTRICTION
This drawing is the property of the Architect and may not be copied or reproduced without the written permission of the Architect.


PROJECT NO. 2012110.00 DATE 6 JUNE 2012

SHEET NO.

A-1

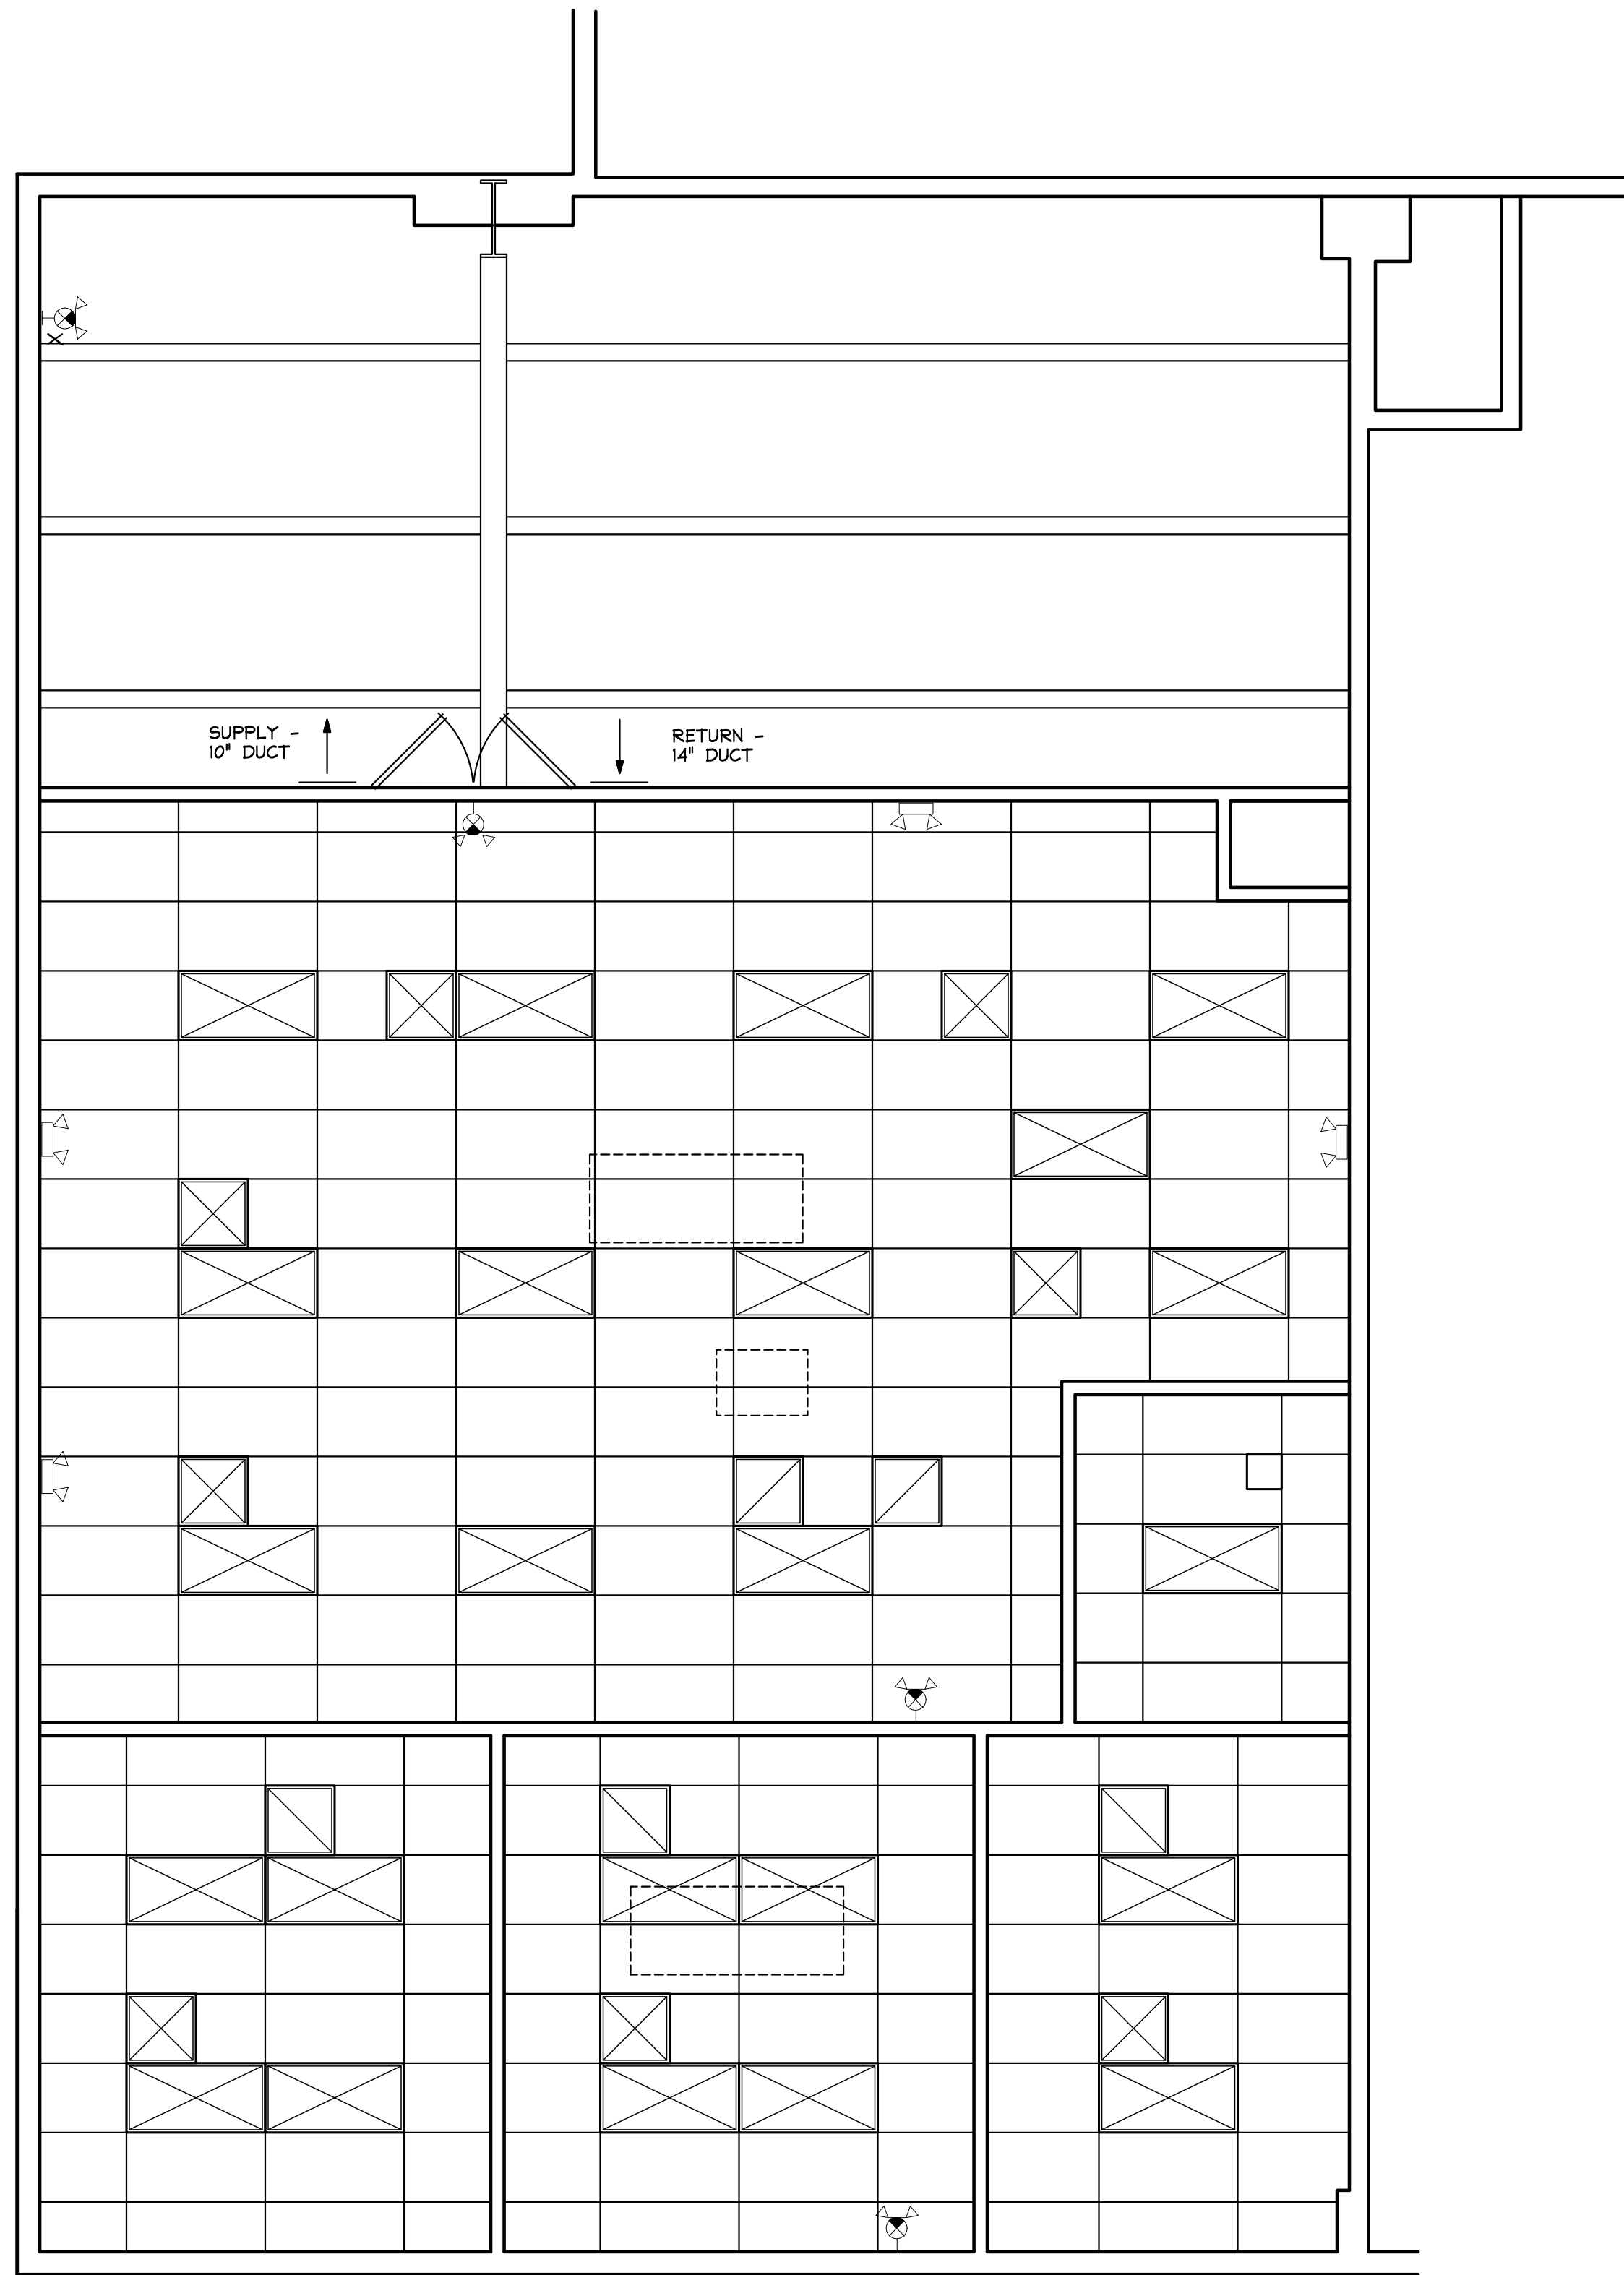

SUITE 8
REFLECTED CEILING PLAN
SCALE: 1/4" = 1'-0"

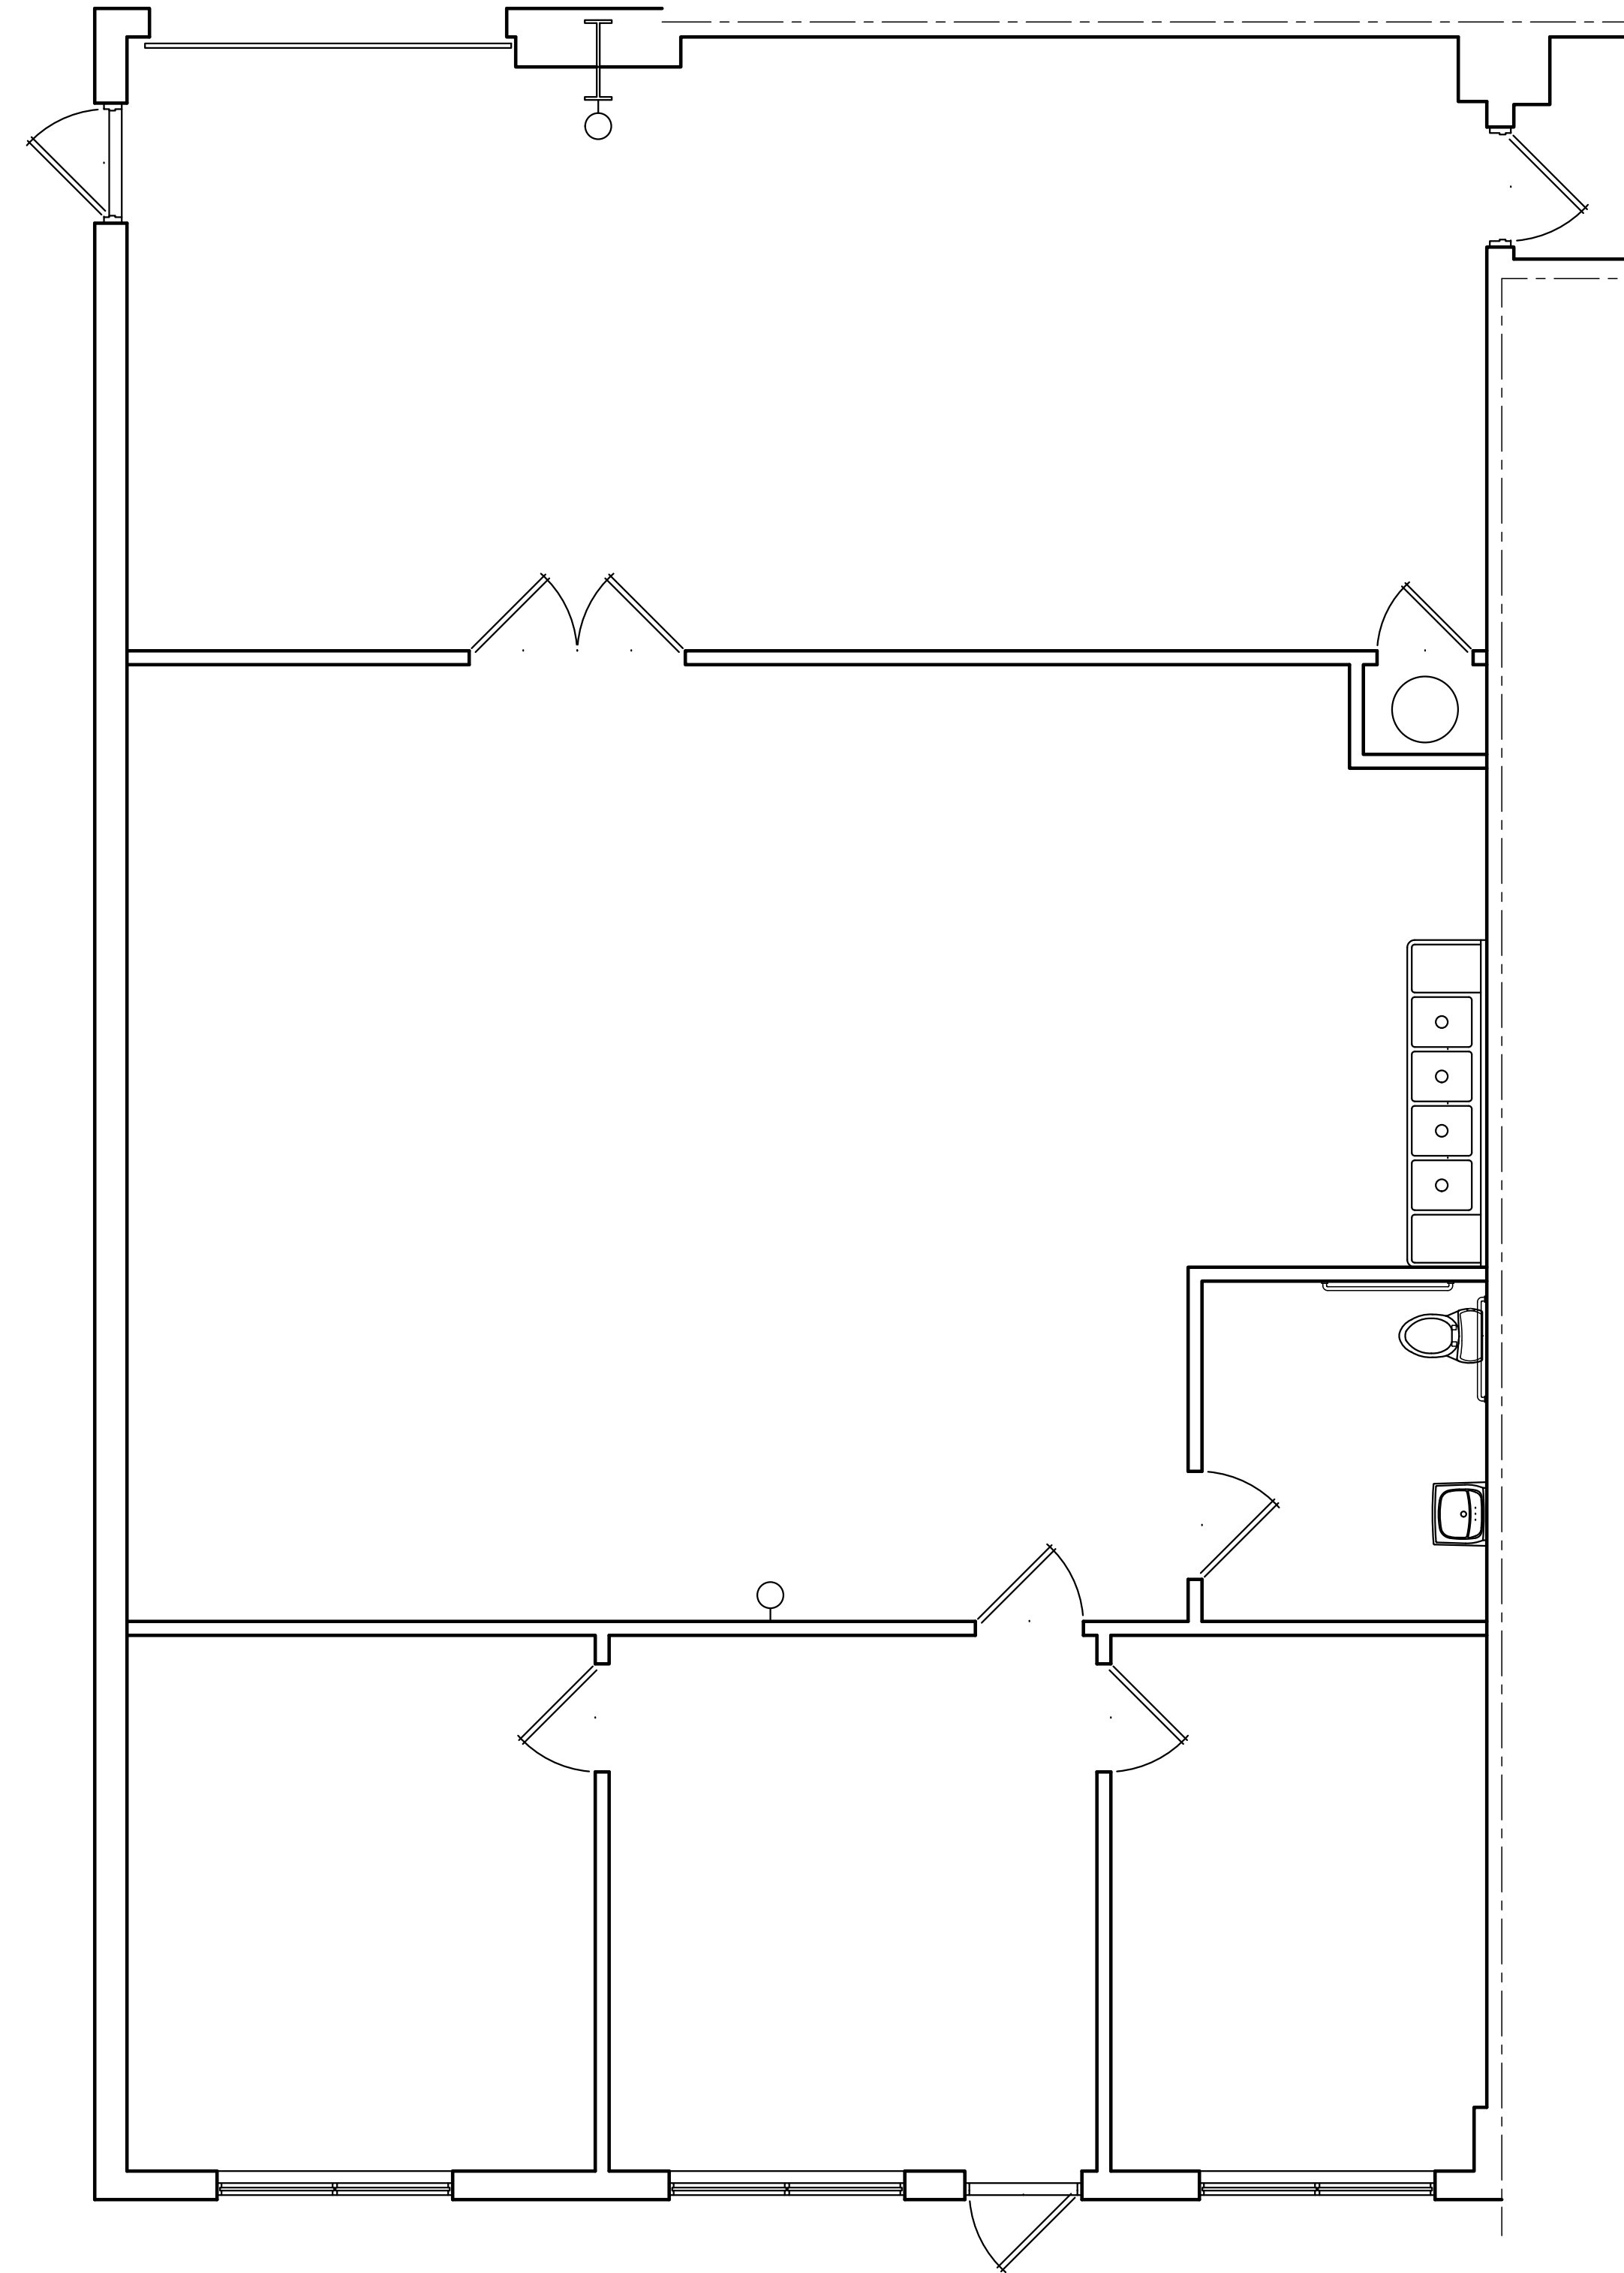


SUITE 8 PLAN
SCALE: 1/4" = 1'-0"

BUILDING AREA
SUITE 8 - 2,397 SQ. FT.

DATE	REV. NO.	DESCRIPTION

West & Associates
ARCHITECTS

4389 SHELDORNE DRIVE, DUNWOODY, GEORGIA 30338-8615 (770) 457-4495

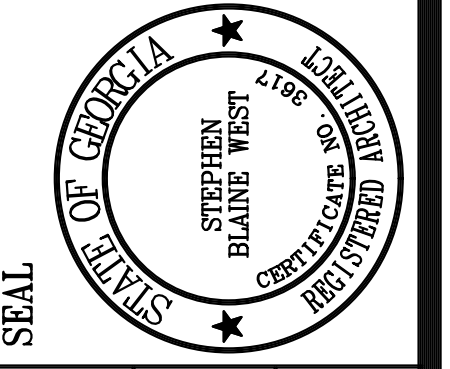

DRAWN
CHECKED
APPROVED

SHEET TITLE
SUITE 8 PLAN & REFLECTED CEILING PLAN

PROJECT NAME
AS-BUILT SURVEY
FOR 120 GLOSTER RD. - LAWRENCEVILLE, GA

REPRODUCTION RESTRICTION
This drawing is the property of the Architect and may not be copied or reproduced without the written permission of the Architect.

PROJECT NO.	DATE
2012110.00	6 JUNE 2012

SHEET NO.